

CONTRACT NO / TO NO: N62473-10-D-0808		PROJECT TITLE / LOCATION: Rad Remediation D-1, Phase II / HPNS		ITSI GILBANE PROJECT NO: 07204.0004	
Survey No.: 07204.0004-0911-INF		Date: 7/16/2014		Location: HPNS	
Chris Robbins				Ed Palser	
Tech Printed Name		Signature		RSO Printed Name	
				Signature	

Instrument(s)

Model	Serial	Cal Due Date	Probe Model	Probe Serial	Cal Due Date	BKG α	BKG β	BKG γ	BKG μr/Hr	Eff. α	Eff. β
19	286213	7/27/2014	N/A						5.4	N/A	
N/A											
N/A											

Survey Description / Map /Photo

Survey Unit

G

Trench #:

04-PDT-007

Soil Survey Units

D0027	D0019	N/A	→	N/A
N/A			→	N/A

(D0001 to D0042)

From the Bottom of Trench

Soil Compaction Lift From
Soil Compaction Lift From

0	ft to	1
1	ft to	2
2	ft to	3
3	ft to	4
4	ft to	5
5	ft to	6
6	ft to	7
7	ft to	8
8	ft to	9
9	ft to	10
10	ft to	11

μR/Hr μR/Hr μR/Hr μR/Hr

6	5	5	5
5	5	5	6
5	5	6	6
6	5	5	5
6	6	5	6
N/A	N/A	N/A	N/A
↓	↓	↓	↓

Comments: Informational Survey During Backfill Operation. Dose rates taken at 1 meter above surface to support RESRAD model. Model 19 BKGD from taken from instrument set up sheet.

DATE: 12/13/2013
TIME: 1:22 PM
USER: jgibane

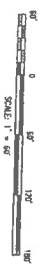

Sheet reference number:
1 of 2


VERIFY SCALE
BASED ON ONE INCH ON ORIGINAL DRAWING
IF NOT ONE INCH ON THIS SHEET, ADJUST SCALE ACCORDINGLY


RADIOLOGICAL REMEDIATION AND SUPPORT
PARCEL D-1, PHASE II
HUNTERS POINT NAVAL SHIPYARD
SAN FRANCISCO, CALIFORNIA

AS-BUILT PLANS
DECEMBER 2013

TRENCH EXCAVATION
LAYOUT PLAN

TSI Gilbane
2730 Shadelands Drive
Walnut Creek, CA. 94598

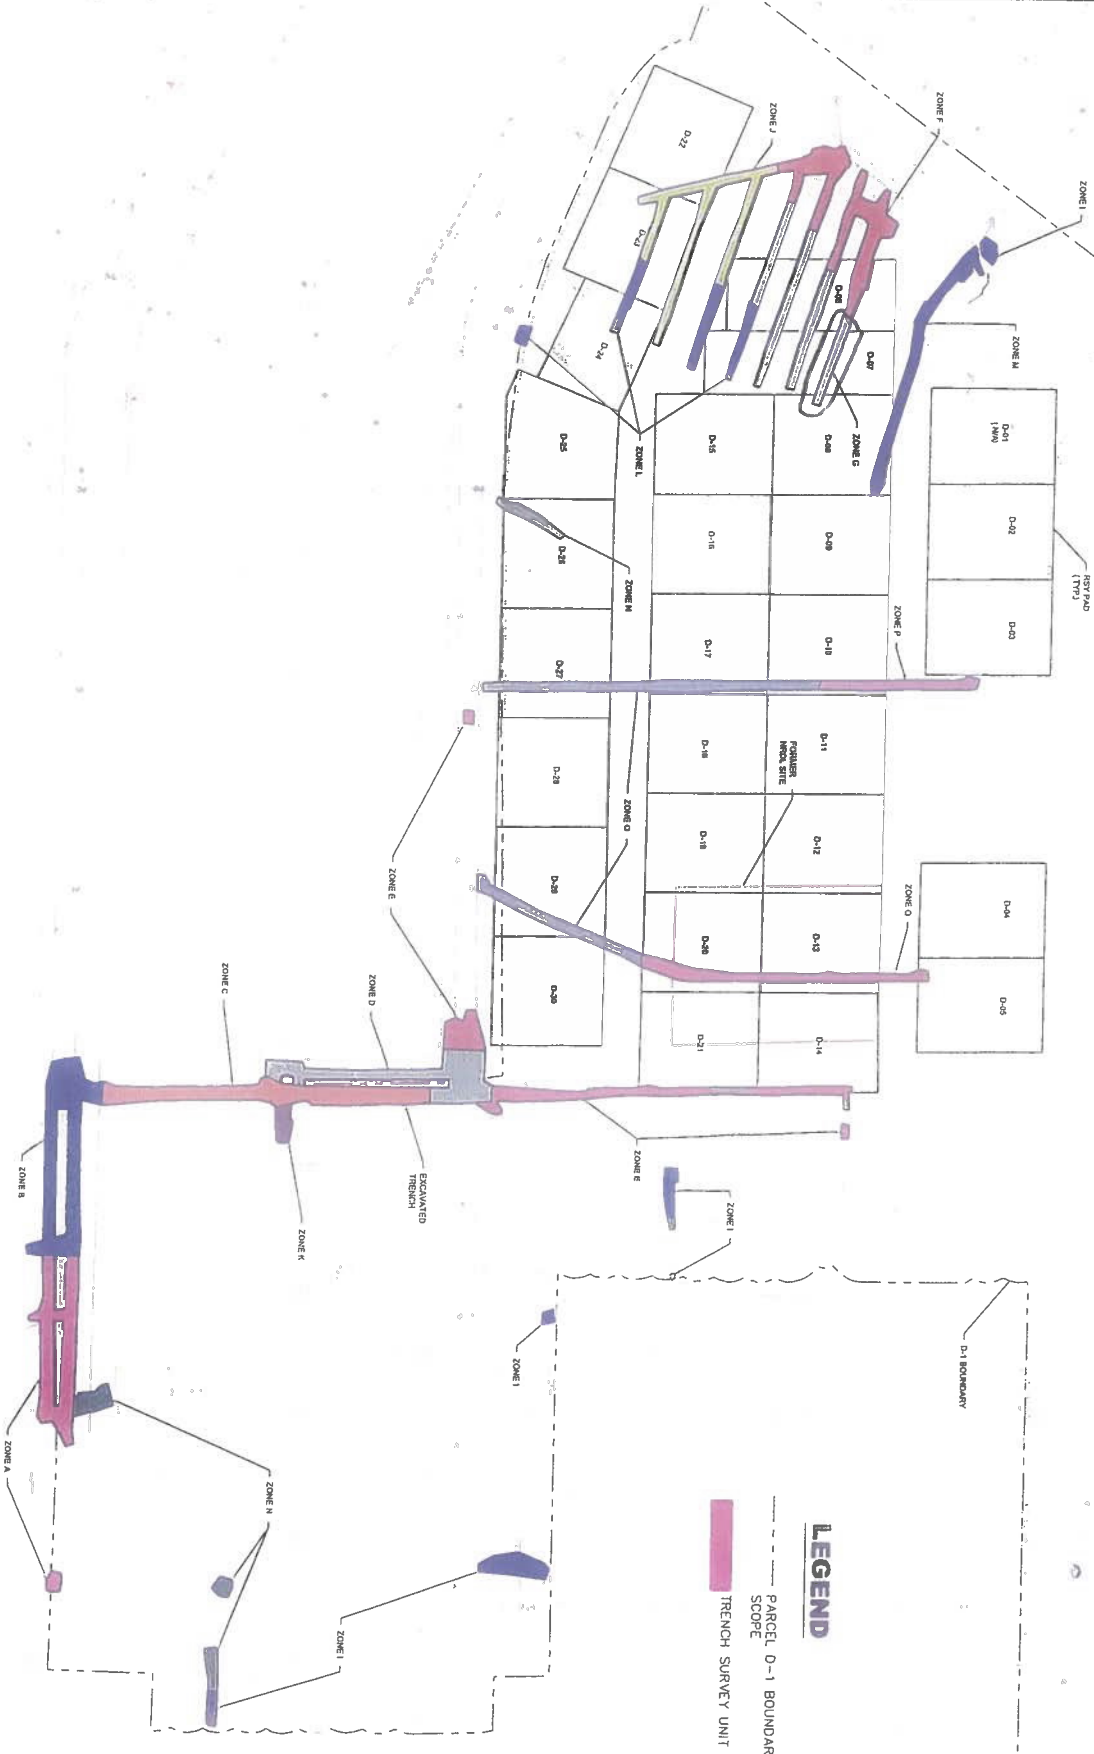

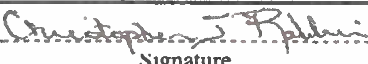CONTRACT NO / TO NO: N62473-10-D-0808		PROJECT TITLE / LOCATION: Rad Remediation D-1, Phase II / HPNS		ITSI GILBANE PROJECT NO: 07204.0004	
Survey No.: 07204.0004-0911-INF		Date: 7/16/2014		Location: HPNS	
Chris Robbins				Ed Palser	
Tech Printed Name		Signature		RSO Printed Name	
				Signature	

Instrument(s)

Model	Serial	Cal Due Date	Probe Model	Probe Serial	Cal Due Date	BKG α	BKG β	BKG γ	BKG μr/Hr	Eff. α	Eff. β
19	286213	7/27/2014	N/A						5.4	N/A	
N/A											
N/A											

Survey Description / Map /Photo

Survey Unit

G

Trench #:

04-PDT-007

Soil Survey Units

D0027	D0019	N/A		N/A
N/A				N/A


(D0001 to D0042)

From the Bottom of Trench

Soil Compaction Lift From	0	ft to	1
Soil Compaction Lift From	1	ft to	2
Soil Compaction Lift From	2	ft to	3
Soil Compaction Lift From	3	ft to	4
Soil Compaction Lift From	4	ft to	5
Soil Compaction Lift From	5	ft to	6
Soil Compaction Lift From	6	ft to	7
Soil Compaction Lift From	7	ft to	8
Soil Compaction Lift From	8	ft to	9
Soil Compaction Lift From	9	ft to	10
Soil Compaction Lift From	10	ft to	11

μR/Hr	μR/Hr	μR/Hr	μR/Hr
5	6	6	5
6	5	5	5
6	6	5	5
5	5	5	6
6	7	6	6
N/A	N/A	N/A	N/A
↓	↓	↓	↓

Comments: Informational Survey During Backfill Operation. Dose rates taken at 1 meter above surface to support RESRAD model. Model 19 BKGD from taken from instrument set up sheet.

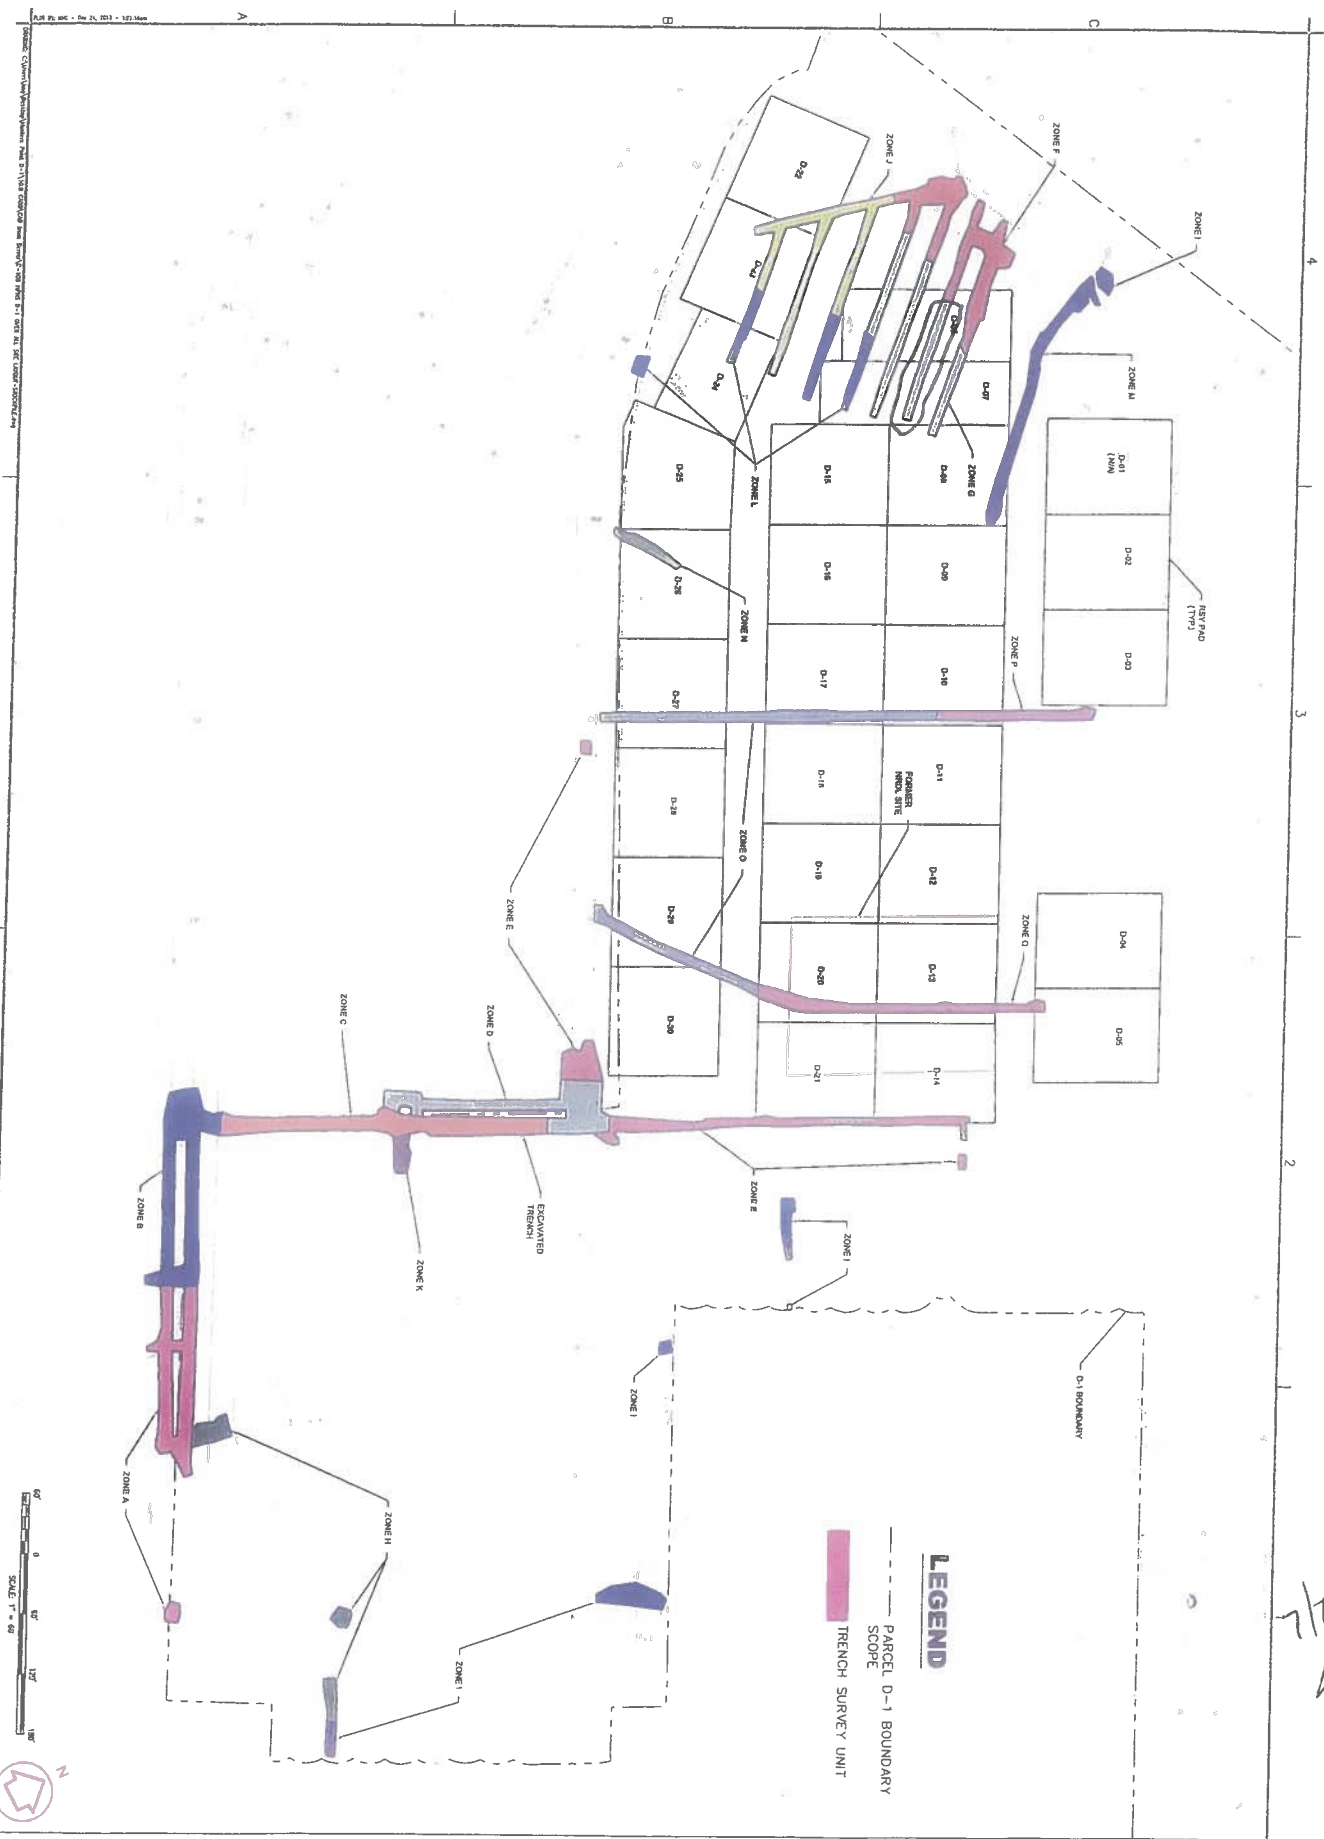

7/2/14
[Signature]

07204.0004-911-Inf

Page 4 of 8

CONTRACT NO / TO NO: N62473-10-D-0808		PROJECT TITLE / LOCATION: Rad Remediation D-1, Phase II / HPNS		ITSI GILBANE PROJECT NO: 07204.0004	
Survey No.: 07204.0004-0911-INF		Date: 7/16/2014		Location: HPNS	
Chris Robbins		<i>Christopher J Robbins</i>		Ed Palser	
Tech Printed Name		Signature		RSO Printed Name	
				Signature	

Instrument(s)

Model	Serial	Cal Due Date	Probe Model	Probe Serial	Cal Due Date	BKG α	BKG β	BKG γ	BKG μr/Hr	Eff. α	Eff. β
19	286213	7/27/2014	N/A						5.4	N/A	
N/A											
N/A											

Survey Description / Map /Photo

Survey Unit

G

Trench #:

04-PDT-007

Soil Survey Units

D0027	D0019	N/A	→	N/A
N/A			→	N/A

(D0001 to D0042)

From the Bottom of Trench

Soil Compaction Lift From	0	ft to	1
Soil Compaction Lift From	1	ft to	2
Soil Compaction Lift From	2	ft to	3
Soil Compaction Lift From	3	ft to	4
Soil Compaction Lift From	4	ft to	5
Soil Compaction Lift From	5	ft to	6
Soil Compaction Lift From	6	ft to	7
Soil Compaction Lift From	7	ft to	8
Soil Compaction Lift From	8	ft to	9
Soil Compaction Lift From	9	ft to	10
Soil Compaction Lift From	10	ft to	11

μR/Hr	μR/Hr	μR/Hr	μR/Hr
5	6	6	6
6	6	5	6
5	6	5	6
6	5	5	5
6	6	5	6
N/A	N/A	N/A	N/A
↓	↓	↓	↓

Comments: Informational Survey During Backfill Operation. Dose rates taken at 1 meter above surface to support RESRAD model. Model 19 BKGD from taken from instrument set up sheet.

PROJECT: C:\Users\jgibane\Documents\Parcel D-1\AS-BUILT\AS-BUILT-2013-121-MW.dwg
 DATE: 12/27/13
 DRAWN BY: jgibane
 CHECKED BY: jgibane



Sheet
 reference
 number:
 1 of 2

VERIFY SCALE
 BAR IS ONE INCH ON
 ORIGINAL DRAWING
 IF NOT ONE INCH ON
 THIS SHEET, ADJUST
 SCALE ACCORDINGLY

RADIOLOGICAL REMEDIATION AND SUPPORT
 PARCEL D-1, PHASE II
 HUNTERS POINT NAVAL SHIPYARD
 SAN FRANCISCO, CALIFORNIA

AS-BUILT PLANS
 DECEMBER 2013


TRENCH EXCAVATION
 LAYOUT PLAN

TSI Gilbane
 2730 Shadelands Drive
 Walnut Creek, CA, 94598

07204-0004-911-Inf

Page 1 of 8

12/27/13

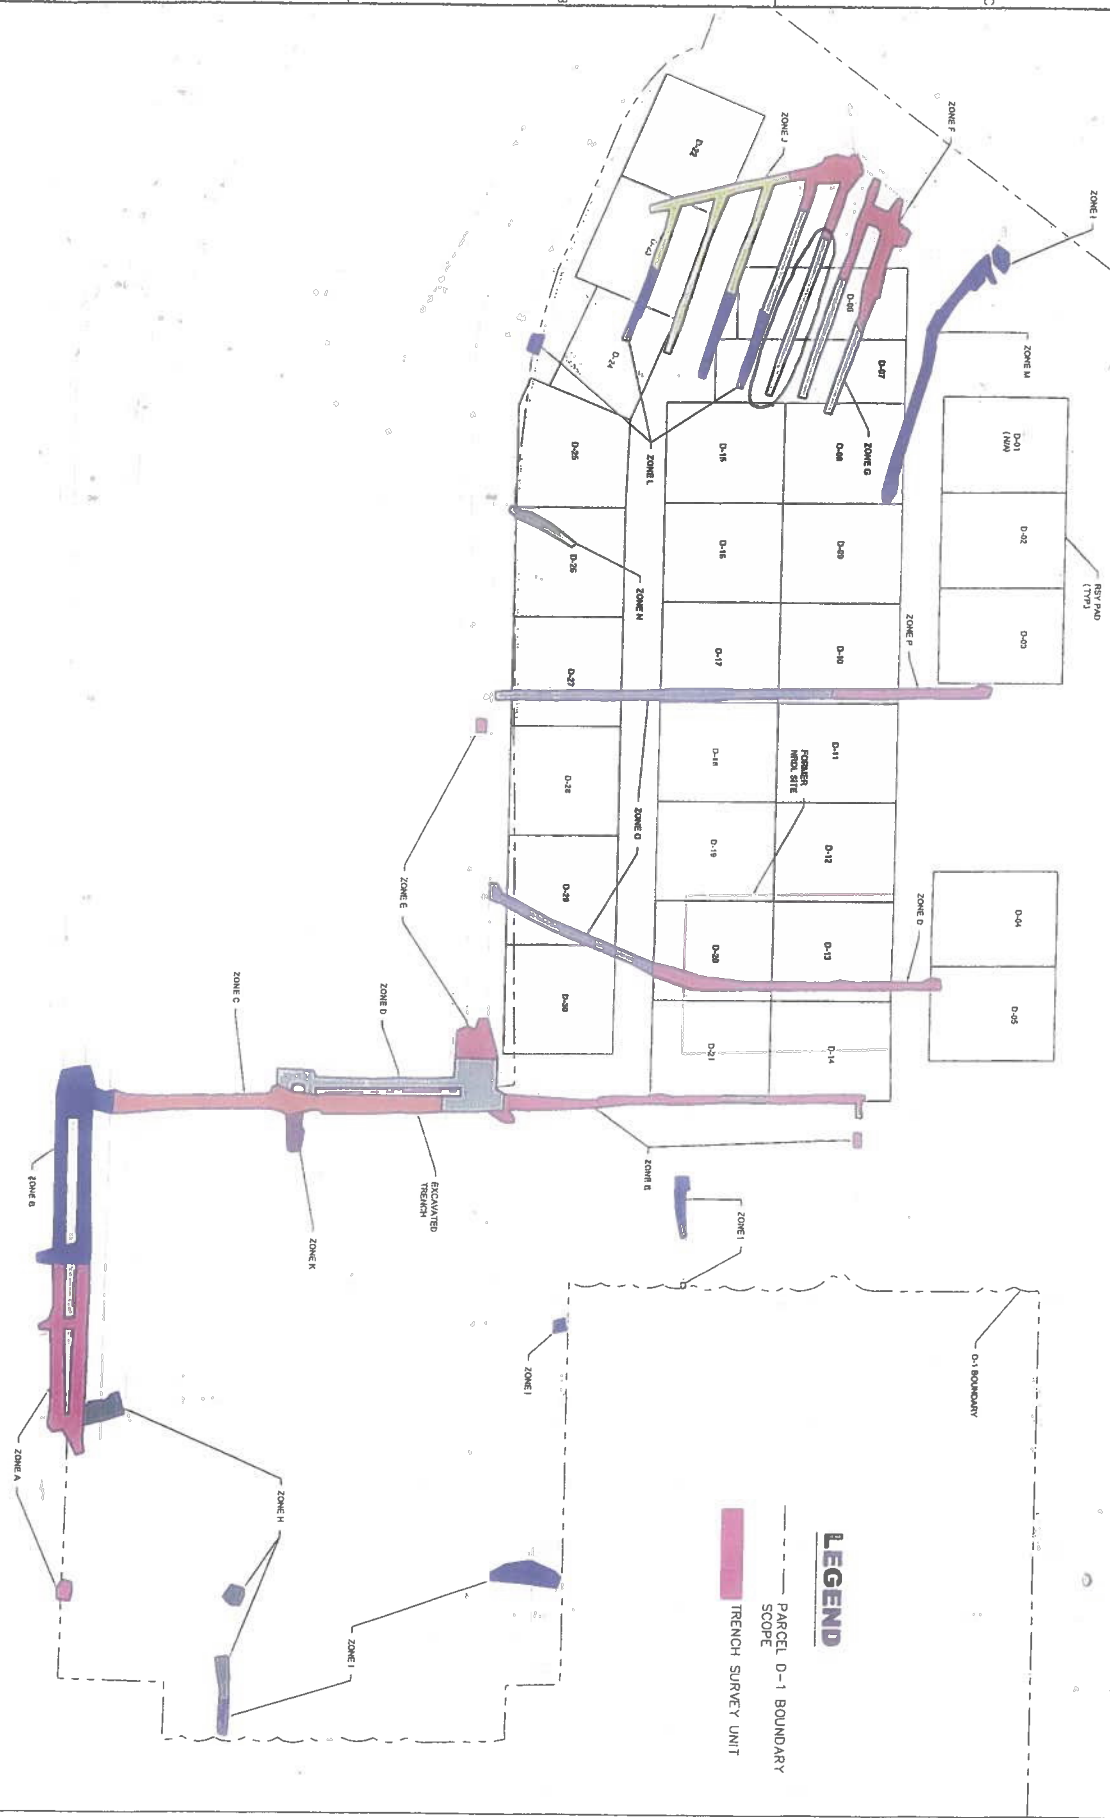

- LEGEND**
- PARCEL D-1 BOUNDARY
 - SCOPE
 - TRENCH SURVEY UNIT

CONTRACT NO / TO NO: N62473-10-D-0808		PROJECT TITLE / LOCATION: Rad Remediation D-1, Phase II / HPNS		ITSI GILBANE PROJECT NO: 07204.0004	
Survey No.: 07204.0004-0911-INF		Date: 7/16/2014		Location: HPNS	
Chris Robbins				Ed Palser	
Tech Printed Name		Signature		RSO Printed Name	
				Signature	

Instrument(s)

Model	Serial	Cal Due Date	Probe Model	Probe Serial	Cal Due Date	BKG α	BKG β	BKG γ	BKG μr/Hr	Eff. α	Eff. β
19	286213	7/27/2014	N/A						5.4	N/A	
N/A											
N/A											

Survey Description / Map /Photo

Survey Unit G

Trench #: 04-PDT-007

Soil Survey Units

D0027	D0019	N/A	→	N/A
N/A			→	N/A

(D0001 to D0042)

From the Bottom of Trench

Soil Compaction Lift From	0	ft to	1
Soil Compaction Lift From	1	ft to	2
Soil Compaction Lift From	2	ft to	3
Soil Compaction Lift From	3	ft to	4
Soil Compaction Lift From	4	ft to	5
Soil Compaction Lift From	5	ft to	6
Soil Compaction Lift From	6	ft to	7
Soil Compaction Lift From	7	ft to	8
Soil Compaction Lift From	8	ft to	9
Soil Compaction Lift From	9	ft to	10
Soil Compaction Lift From	10	ft to	11

μR/Hr	μR/Hr	μR/Hr	μR/Hr
6	6	6	6
6	6	5	6
6	7	6	6
5	6	6	6
6	6	6	7
N/A	N/A	N/A	7
↓	↓	↓	↓

Comments: Informational Survey During Backfill Operation. Dose rates taken at 1 meter above surface to support RESRAD model. Model 19 BKGD from taken from instrument set up sheet.



7/29/14
[Signature]

07204-0004-911-1000

Page 8 of 8